

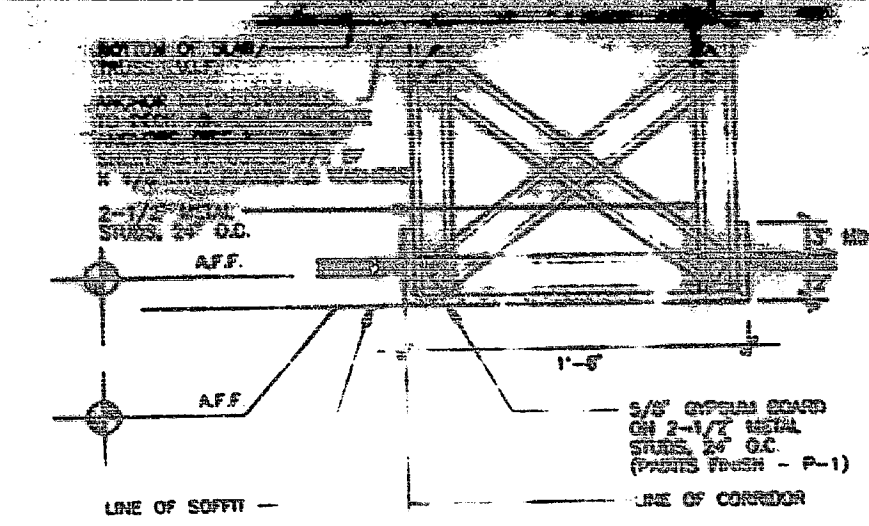


A 105
CANTOR FITZGERALD
A4.2


TAA # 941154
5/1/95

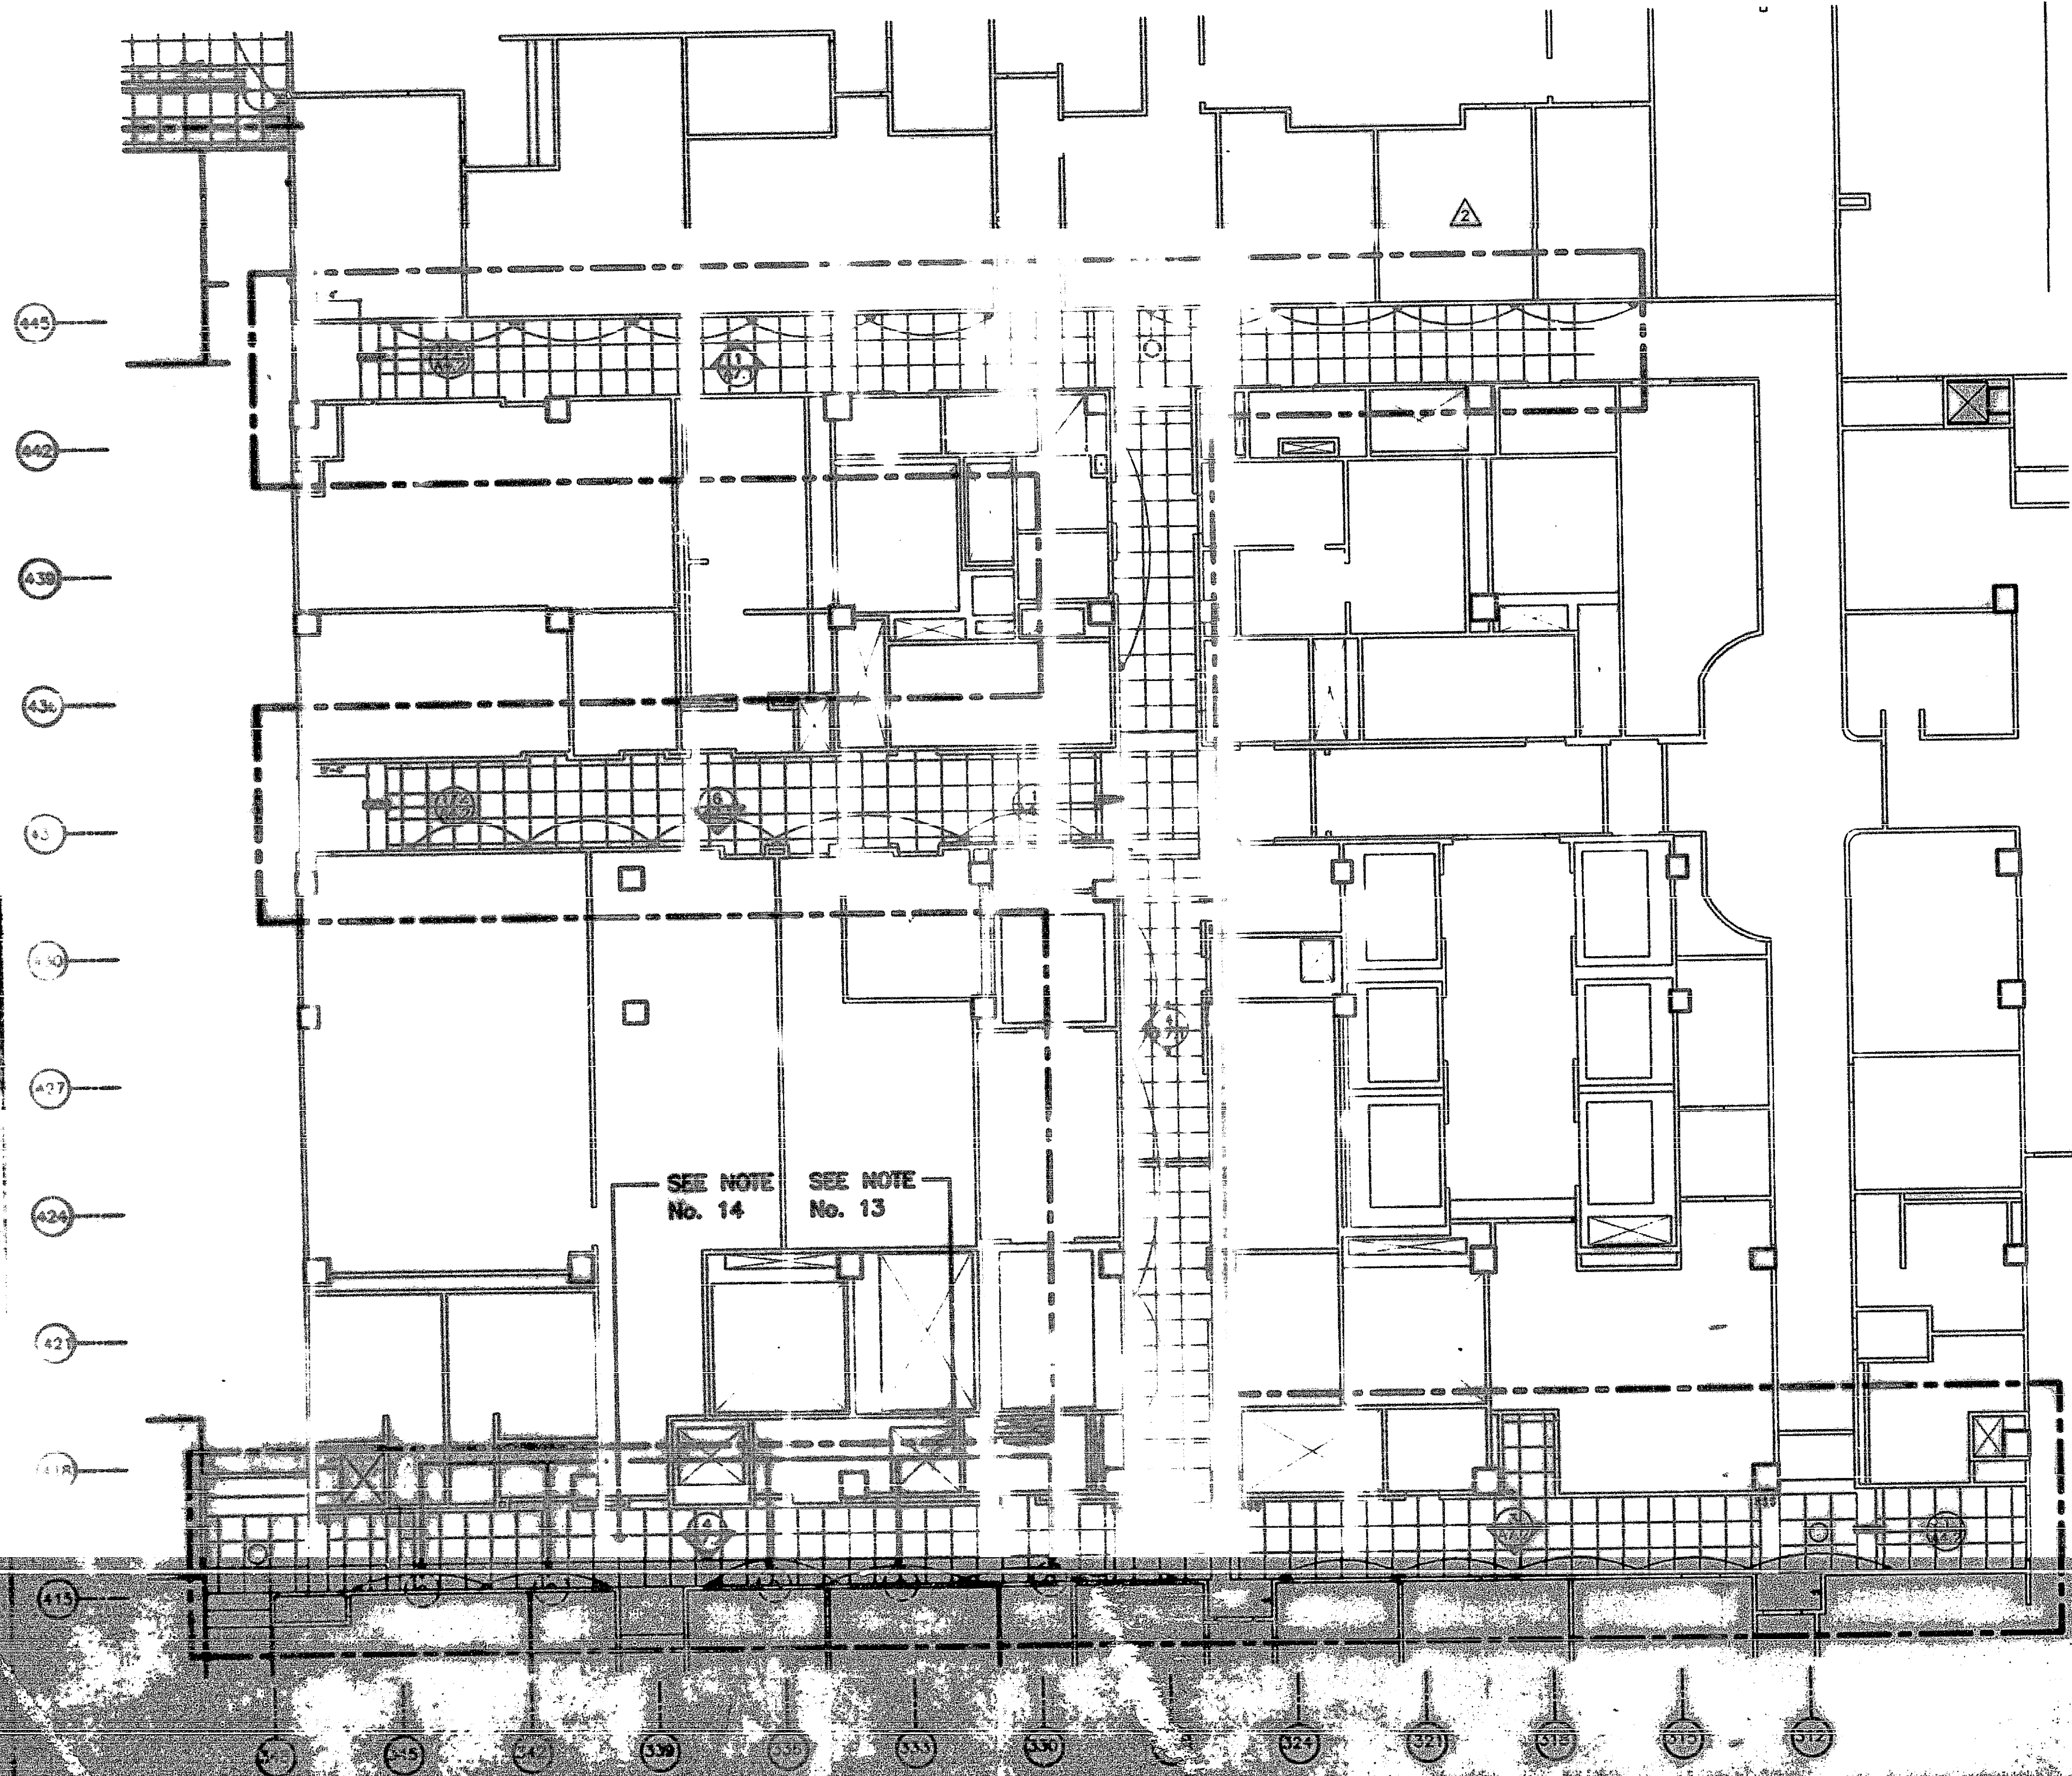

1 DETAIL 1 GYP. LD. SOFFIT
SCALE: 1"=1'-0"

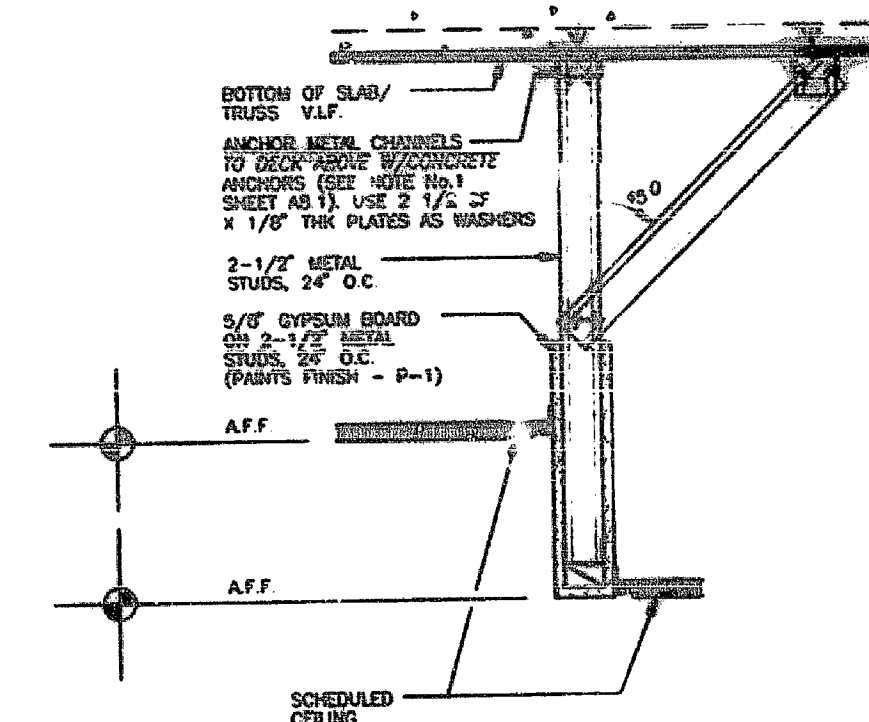

2 DETAIL 2 CHANGE IN CLG. HT.
SCALE: 1"=1'-0"

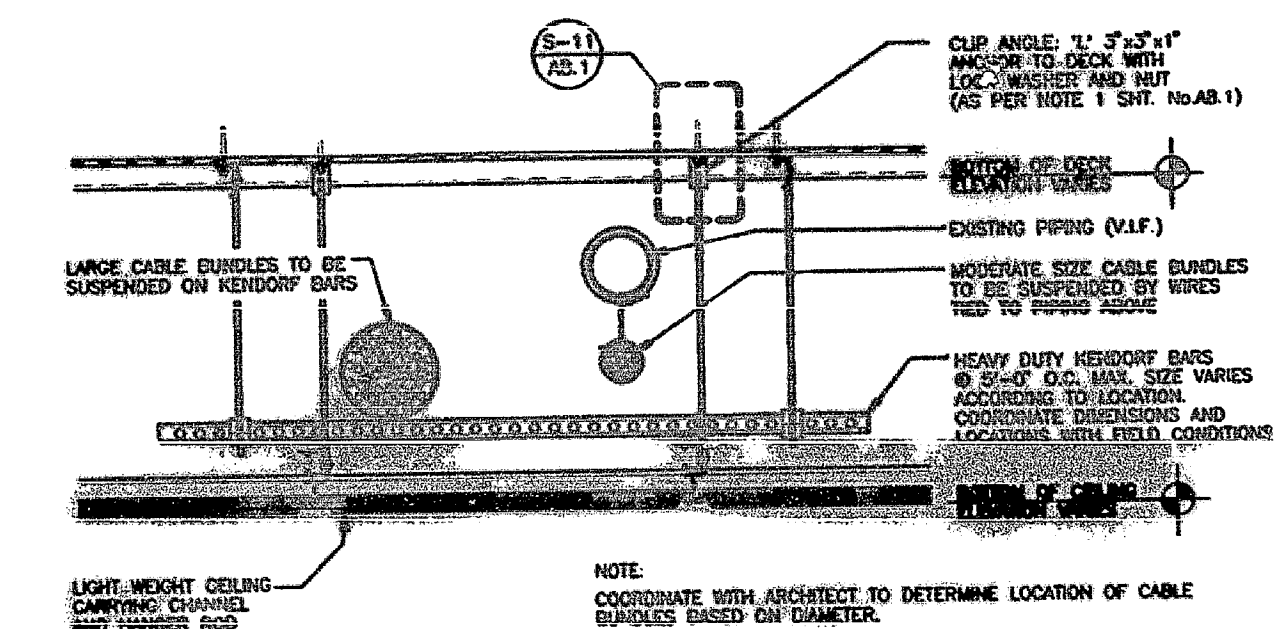


3 DETAIL 3 CABLE SUPPORT
SCALE: 1"=1'-0"

NOTES

- 2x2' ACOUSTIC CEILING
TILE (SEE FINISH
SCHEDULE A7.0)
- SUSPENDED INDIRECT
LIGHTING -
LEDALITE BEAM 1
2 LAMP T8, 277V.
- WALL SCONCE
VISA LIGHTING COLONNADE
CB3550-BA WALL MOUNTED
277V, 1-27W FLUORESCENT
- SURFACE MOUNTED
CEILING FIXTURE
LOUIS POULSEN AJF-809
120V, NPF 2/13W/CF
- FIXTURE
RECESSED FLUORESCENT
LIGHTING -
2x4\"/>

- DELETED
- DELETED
- "SMOKERS" EXHAUST FAN / GRILLE; REFER TO
MECHANICAL DRGS. - SHEET M-2 FOR
ADDITIONAL INFORMATION
- ALL SUSPENDED INDIRECT LIGHTING LENGTHS
ARE NOMINAL - VERIFY ACTUAL
- CEILING HEIGHT IS ABOVE FINISH FLOOR OR SLAB
COORDINATE WITH RAISED FLOOR OR SLAB
- STARTING LINE OF ACOUSTIC TILE CEILING
- ALL ANCHORS ATTACHED TO SLAB/METAL DECK
ABOVE TO BE ANCHORED TO THE TOP OF THE
METAL DECK RIG W/ EXPANSION FASTENERS
(NO DRILLED EXPANSION ANCHORS INTO SLAB
OR TRUSSES) - TYPICAL SEE P.A. NOTES A8.1
- FOR HEIGHT & SPACING OF WALL SCONCES
SEE ELEVATIONS SHEET A6-SW
- N/A
- FOR DIRECTIONAL EXIT SIGNS AND STROBE LIGHT
LOCATIONS SEE ENGINEERS DRAWING No. E-3
- REMOVE EXISTING WALL SCONCE AND REUSE.
PATCH AND PAINT WALL TO MATCH ADJACENT
SURFACES
- EXISTING 2 x 2 CEILING IN THIS AREA TO REMAIN
- CONTRACTOR TO PATCH ALL NEW AND EXISTING
PARTITION OPENINGS ABOVE CEILING AS WELL AS
SEAL AROUND ALL PENETRATIONS WITH
EXPANDABLE FOAM FILLER.
- CONTRACTOR TO SUSPEND EXISTING DATA CABLES
OFF OF AND INDEPENDENT OF BLACK IRON
SIMILAR TO FIXTURE DETAIL 3/A4.1.
- CONTRACTOR TO USE THIS PLAN FOR FUTURE COORD.
AND APPROX. LOCATION.
USE ELEVATIONS ON A7.1 & A7.2 FOR ACTUAL
DIMENSIONED LOCATIONS.
- WALL SCONCE BREAKDOWN:
(14) CURRENTLY INSTALLED
(8) EXISTING TO REMAIN
(6) EXISTING TO BE RELOCATED
(28) TO BE INSTALLED
(FIXTURES FURNISHED BY OWNER)
- NO NEW ACOUSTICAL CEILING TILE/SYSTEM
AT CORRIDORS, HOWEVER NOTES Nos. 15 & 16
STIL APPLICABLE.

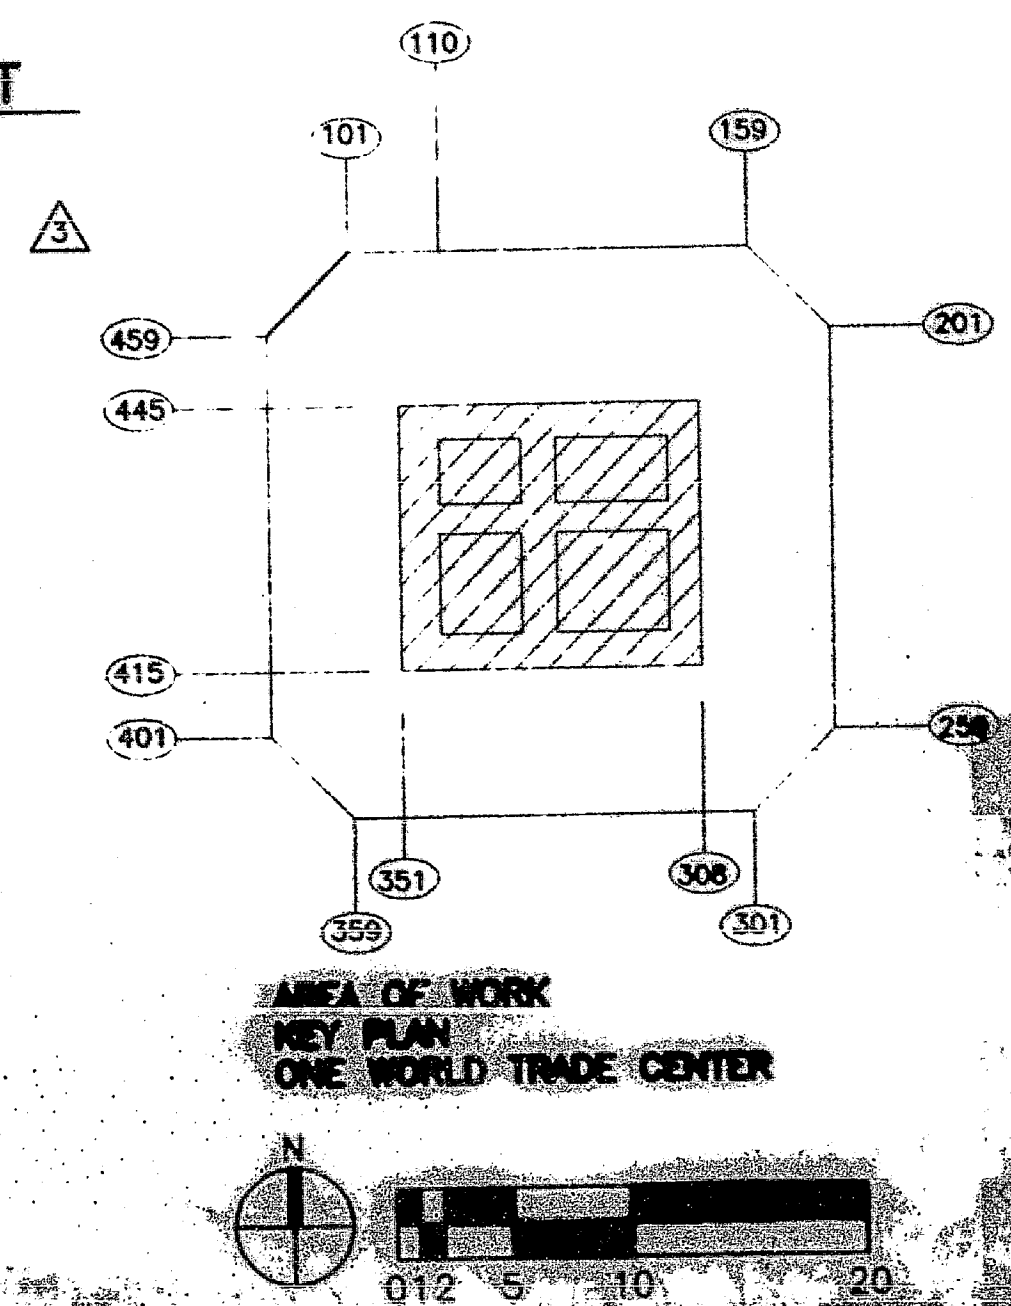

No.	Revision	Issued	Revised
1	11.14.94	REVISED AS PER AUTHORITY	0
2	1.16.95	REVISED AS PER TENDRY	0
3	5.1.95	"AS-BUILT"	0

REFLECTED
CEILING
PLAN

TAA # 941154

Project No. 94160

Date 10.10.94

Drawn By. [Signature]

Checked By. [Signature]

Approved By. [Signature]

Scale: 1/8"=1'-0"

Sheet: A4.2

FLOOR 105